
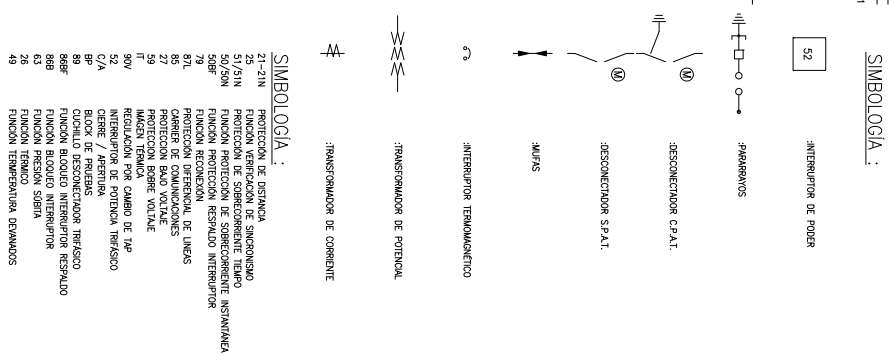
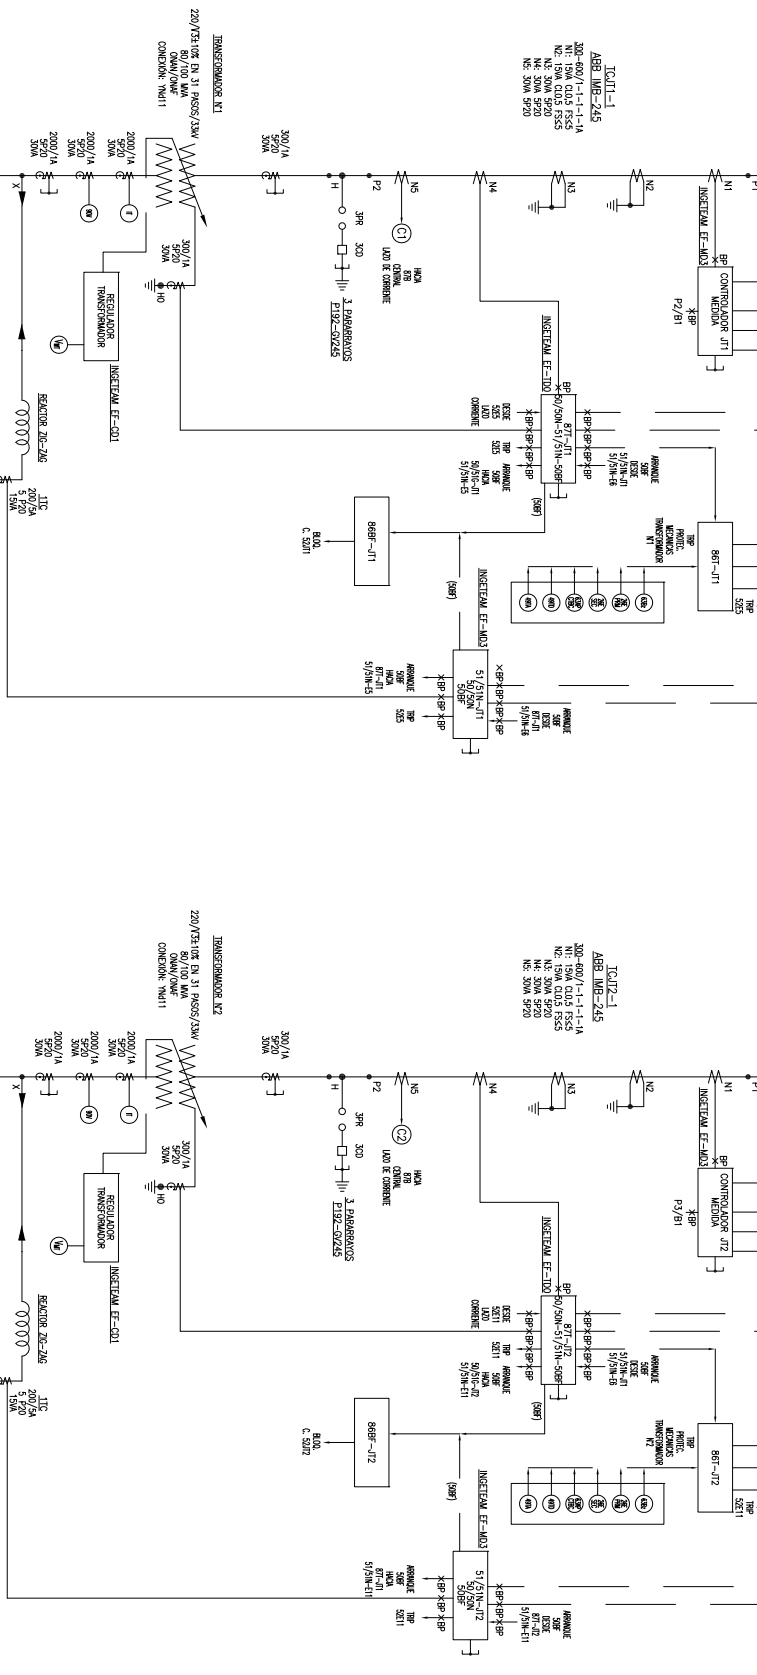
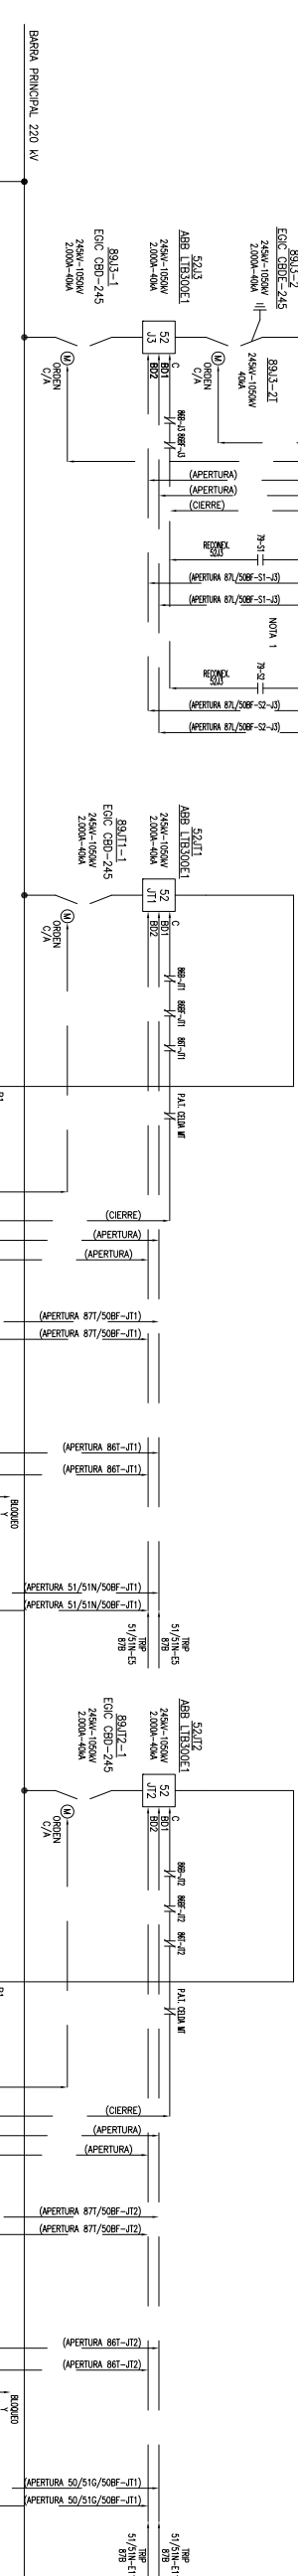
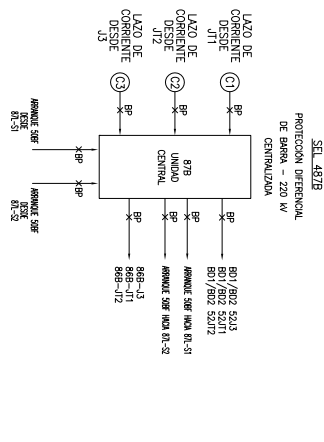


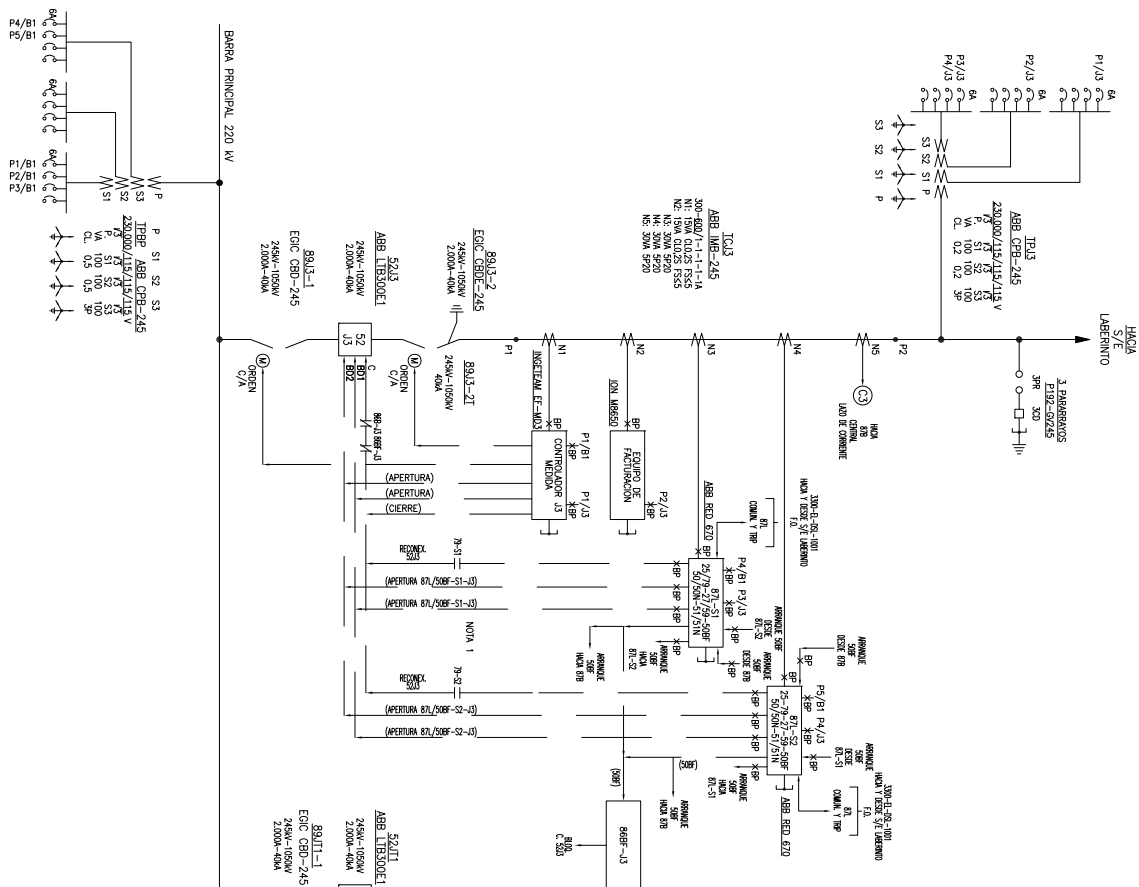

AS-BUILT

[illegible]

oneway ON WAY TEAM		SHEET A / SCALE	
PROJECTO FOTOVOLTAICO SUBJECT: No. 109022-00024		PERMISSIONS AND ENGINEERING SI/NOs (as needed)	
The signature of this drawing belongs to the author/primary designer and should be applied only for the purposes of this project.		CUSTOMERS	
DWG No. 109022-00024-3-100-EI-DSI-1001		REF 7	
PROJECTO FOTOVOLTAICO BOLETO (EX-PROYECTO LABERINTO) SUBESTACION BOLETO DIAGRAMA UNILINEAL 220kV		TV WORLEYPARSONS WORLEYPARSONS cobra COBRA	